



Notification of Hazardous Waste Site

United States
Environmental Protection
Agency
Washington DC 20460

This initial notification information is required by Section 103(c) of the Comprehensive Environmental Response, Compensation, and Liability Act of 1980 and must be mailed by June 9, 1981.

Please type or print in ink. If you need additional space, use separate sheets of paper. Indicate the letter of the item which applies.

810608
SC5000001083

SCD 003 354412

A Person Required to Notify:

Enter the name and address of the person or organization required to notify.

Name SANGAMO CAPACITOR DIVISION

Street P.O. BOX 128/(SANGAMO ROAD)

City PICKENS

Site:
Break: 1.7
Other: v.1
State S.C. Zip Code 29671

B Site Location:

Enter the common name (if known) and actual location of the site.

Name of Site SANGAMO CAPACITOR DIVISION

Street SANGAMO ROAD

City PICKENS

County PICKENS

State S.C.

Zip Code 29671

C Person to Contact:

Enter the name, title (if applicable), and business telephone number of the person to contact regarding information submitted on this form.

Name (Last, First and Title) BUTNER, JESSIE/MFG. SERVICES MGR.

Phone 803/878-6311

D Dates of Waste Handling:

Enter the years that you estimate waste treatment, storage, or disposal began and ended at the site.

From (Year)

1962

To (Year)

1980

SEE ATTACHMENT NO. ONE

E Waste Type: Choose the option you prefer to complete

Option 1: Select general waste types and source categories. If you do not know the general waste types or sources, you are encouraged to describe the site in Item I—Description of Site.

General Type of Waste:

Place an X in the appropriate boxes. The categories listed overlap. Check each applicable category.

1. ☒ Organics
2. ☒ Inorganics
3. ☒ Solvents
4. ☐ Pesticides
5. ☐ Heavy metals
6. ☐ Acids
7. ☐ Bases
8. ☒ PCBs
9. ☒ Mixed Municipal Waste
10. ☐ Unknown
11. ☐ Other (Specify)

Source of Waste:

Place an X in the appropriate boxes.

1. ☐ Mining
2. ☐ Construction
3. ☐ Textiles
4. ☐ Fertilizer
5. ☐ Paper/Printing
6. ☐ Leather Tanning
7. ☐ Iron/Steel Foundry
8. ☐ Chemical, General
9. ☐ Plating/Polishing
10. ☐ Military/Ammunition
11. ☐ Electrical Conductors
12. ☐ Transformers
13. ☐ Utility Companies
14. ☐ Sanitary/Refuse
15. ☐ Photofinish
16. ☐ Lab/Hospital
17. ☐ Unknown
18. ☒ Other (Specify)
FROM THE MFG.
OF CAPACITORS

Option 2: This option is available to persons familiar with the Resource Conservation and Recovery Act (RCRA) Section 3001 regulations (40 CFR Part 261).

Specific Type of Waste:

EPA has assigned a four-digit number to each hazardous waste listed in the regulations under Section 3001 of RCRA. Enter the appropriate four-digit number in the boxes provided. A copy of the list of hazardous wastes and codes can be obtained by contacting the EPA Region serving the State in which the site is located.



Notification of Hazardous Waste Site

Side Two

F Waste Quantity:

Place an X in the appropriate boxes to indicate the facility types found at the site.

In the "total facility waste amount" space give the estimated combined quantity (volume) of hazardous wastes at the site using cubic feet or gallons.

In the "total facility area" space, give the estimated area size which the facilities occupy using square feet or acres.

Facility Type

1. ☒ Piles
2. ☐ Land Treatment
3. ☒ Landfill
4. ☐ Tanks
5. ☒ Impoundment
6. ☐ Underground Injection
7. ☒ Drums, Above Ground
8. ☒ Drums, Below Ground
9. ☐ Other (Specify) _____

Total Facility Waste Amount 800,000cubic feet ~~SEE ATTACHMENT NO. ONE~~

gallons _____

Total Facility Areasquare feet ~~SEE ATTACHMENT NO. ONE~~

acres _____

G Known, Suspected or Likely Releases to the Environment:

Place an X in the appropriate boxes to indicate any known, suspected, ☒ UNKNOWN ☐ Known ☐ Suspected ☐ Likely ☒ None or likely releases of wastes to the environment.

Note: Items H and I are optional. Completing these items will assist EPA and State and local governments in locating and assessing hazardous waste sites. Although completing the items is not required, you are encouraged to do so.

H Sketch Map of Site Location: (Optional)

Sketch a map showing streets, highways, routes or other prominent landmarks near the site. Place an X on the map to indicate the site location. Draw an arrow showing the direction north. You may substitute a publishing map showing the site location.

SEE:

ATTACHMENT NO. TWO-DISPOSAL SITES LOCATED ON SANGAMO PROPERTY.

ATTACHMENT NO. THREE-A TOPOGRAPHIC MAP UPON WHICH SITES 1,2,3,5,7, & 8 LISTED IN ATTACHMENT NO. ONE ARE LOCATED.

ATTACHMENT NO. FOUR-A TOPOGRAPHIC MAP UPON WHICH SITE 4 LISTED IN ATTACHMENT NO. ONE IS LOCATED.

ATTACHMENT NO. FIVE-A TOPOGRAPHIC MAP UPON WHICH SITE 6 LISTED IN ATTACHMENT NO. ONE IS LOCATED.

I Description of Site: (Optional)

Describe the history and present conditions of the site. Give directions to the site and describe any nearby wells, springs, lakes, or housing. Include such information as how waste was disposed and where the waste came from. Provide any other information or comments which may help describe the site conditions.

REF: ATTACHMENTS ONE, TWO, THREE, FOUR, AND FIVE.

J Signature and Title:

The person or authorized representative (such as plant managers, superintendents, trustees or attorneys) of persons required to notify must sign the form and provide a mailing address (if different than address in item A). For other persons providing notification, the signature is optional. Check the boxes which best describe the relationship to the site of the person required to notify. If you are not required to notify check "Other".

Name Mr. Julius C. Hydrick (Vice President)

Street P.O. Box 128

City Pickens

State S.C. Zip Code 29671

Signature

J. Hydrick

Date May 21, 1981

☒ Owner, Present☐ Owner, Past☐ Transporter☐ Operator, Present☐ Operator, Past☐ Other

* Sangamo Property Only

ATTACHMENT NO. ONE

NOTIFICATION OF HAZARDOUS WASTE SITE

EPA FORM 8900-1

NO.	SITE:	PARAGRAPH D:		PARAGRAPH F:		COMMENTS:
		DATES OF WASTE HANDLING		WASTE QUANTITY		
		FROM	TO	VOLUME CUBIC FEET	AREA SQUARE FEET	
1.	Welborn Property	1955	1962	120,000	Unknown	Volume Represents an Estimate of Sangamo Waste only.
2.	Sangamo Property	1962 June 1980	July 1972 Sept. 1980	348,375 467,937	53,165 90,000	Sites No. 3 & No. 4 were Relocated to this Site.
3.	Ernest Nix Property	1964	1965	283,743	72,600	Waste Quantity is Estimated total made up of Sangamo plus other.
4.	Dodgens Property (Trotter)	1966	March 1972	184,194	82,200	Waste Quantity is Estimated total made up of Sangamo plus other.
5.	Brezeal Property	1965	1966	24,000	40,000	Waste Quantity is Estimated total made up of Sangamo plus other.
6.	Cross Roads Church	1966	1966	17,000	Unknown	Volume Represents an Estimate of Sangamo Waste only.
7.	Midway Landfill	March 1972	July 1972	14,500	Unknown	This was a County Landfill, Waste Volume Represents an Estimate of Sangamo Waste only.
8.	County Landfill	July 1972	January 1978	191,600	Unknown	This is a County Landfill, Waste Volume Represents Estimate of Sangamo Waste only.

NOTE: Waste Volumes are made up of non-hazardous as well as hazardous.


ATTACHMENT NO. TWO

PAST LANDFILL AREAS

- 1 20' X 30'
- 2 20' X 30'
- 3 15' X 40'
- 4 15' X 30'
- 5 6' X 50'
- 6 40' X 60'
- 7 20' X 60'
- 8 100' X 150'
- 9 300' X 300'
- 10 20' X 60'
- 11 20' X 40'
- 12 3' X 50'
- 13 6' X 6'
- 14 10' X 50'
- 15 4' X 20'


ACTIVE AREA
(16) SEPTIC TANKS


DOMESTIC WASTE WATER
DISPOSAL

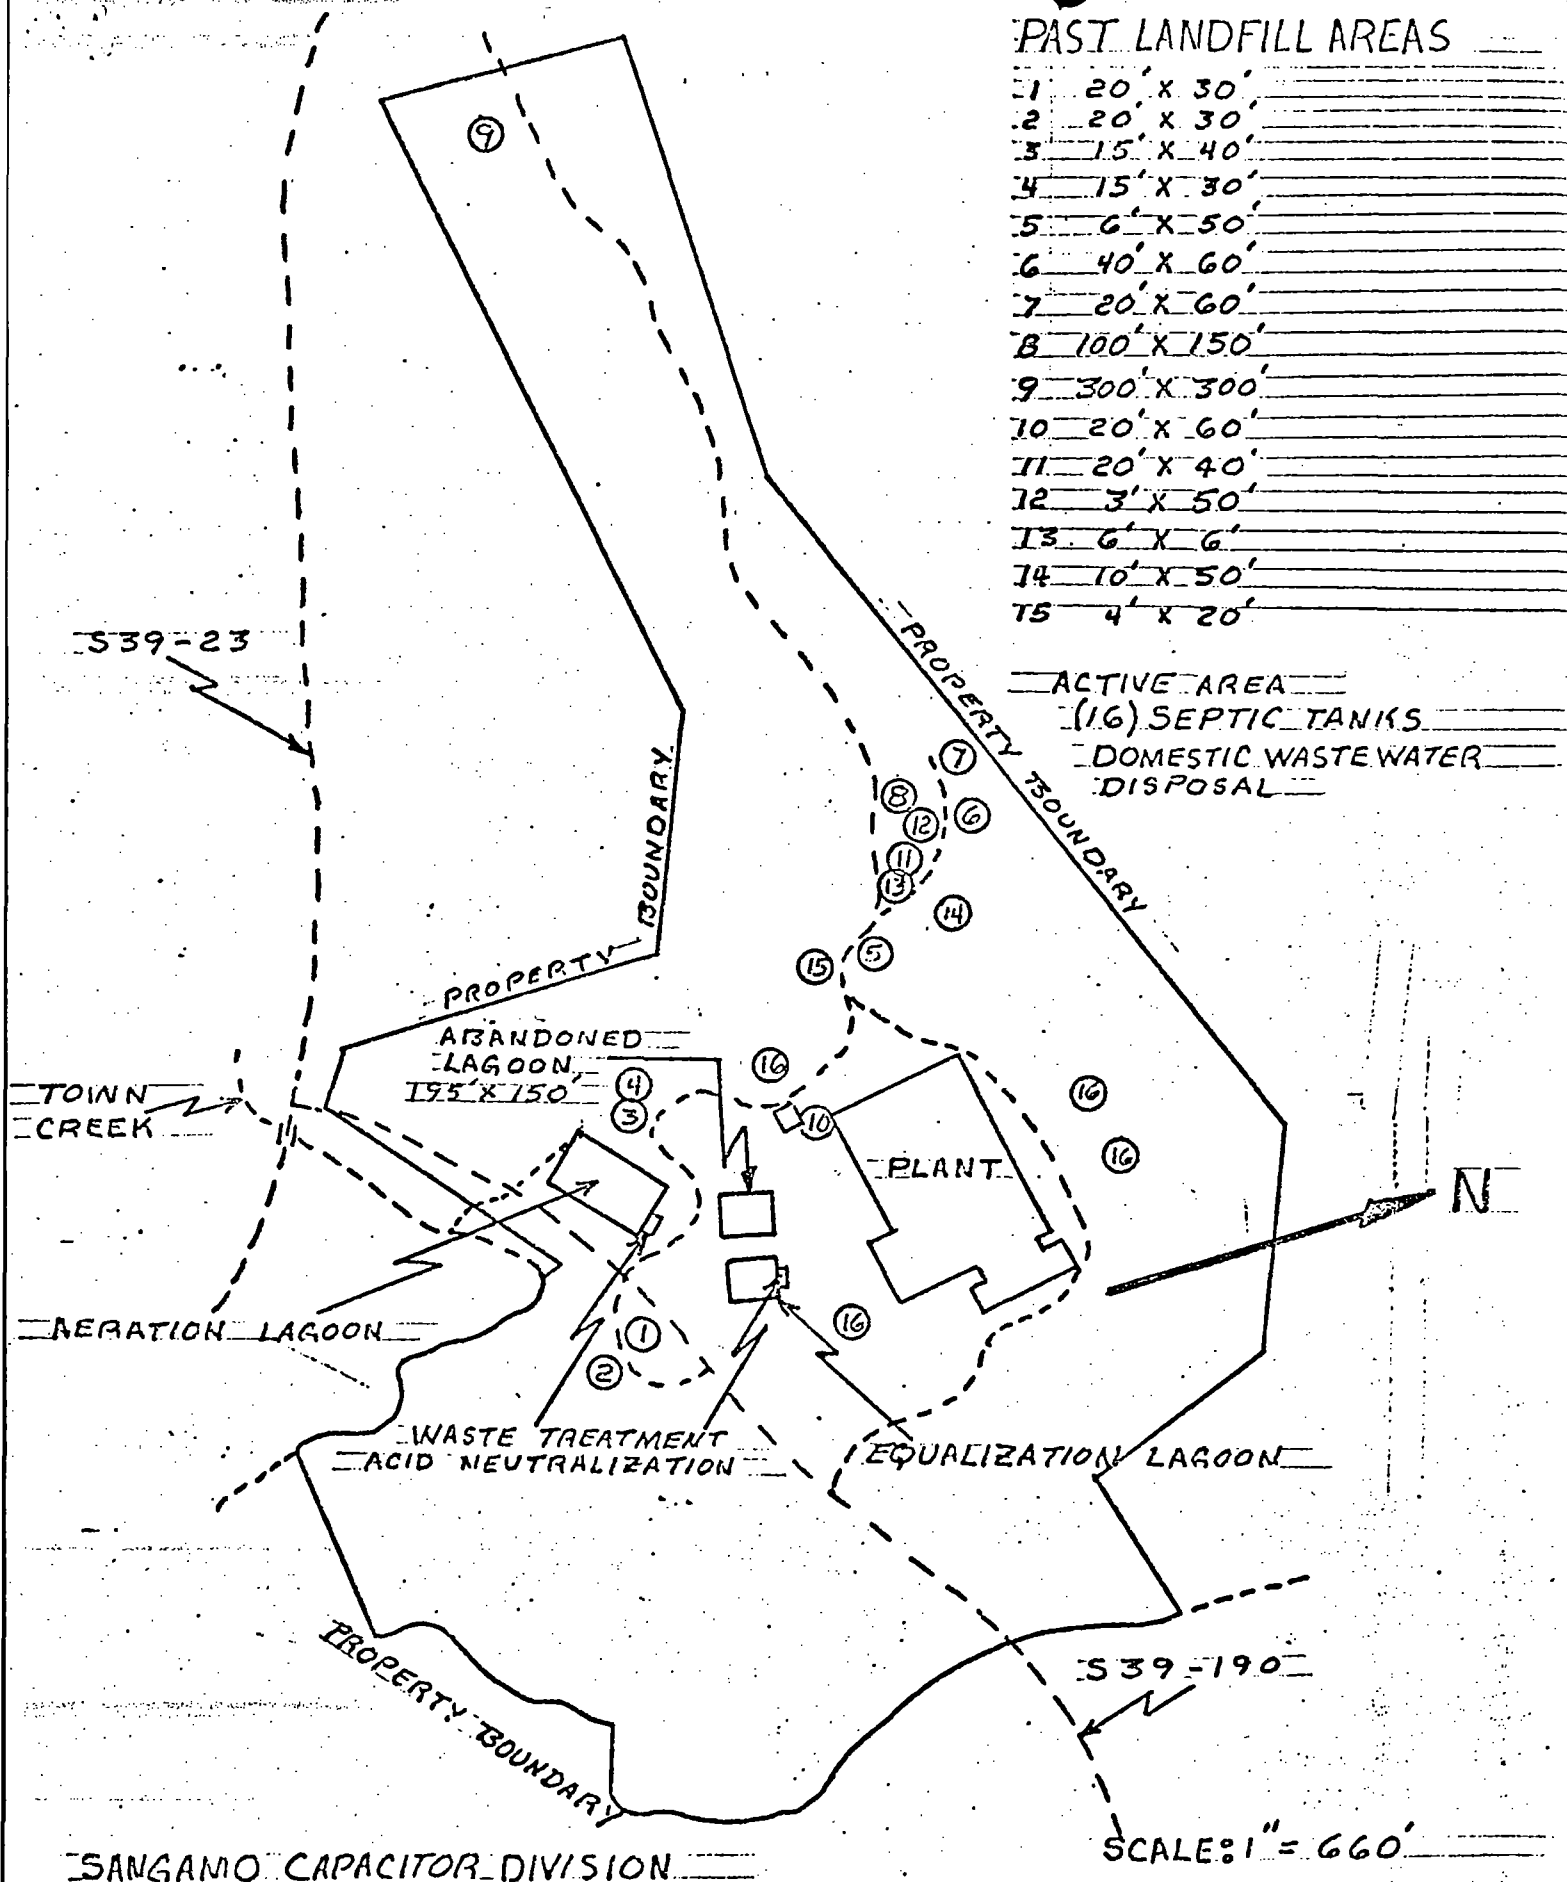

SANGAMO CAPACITOR DIVISION

SCALE: 1" = 660'

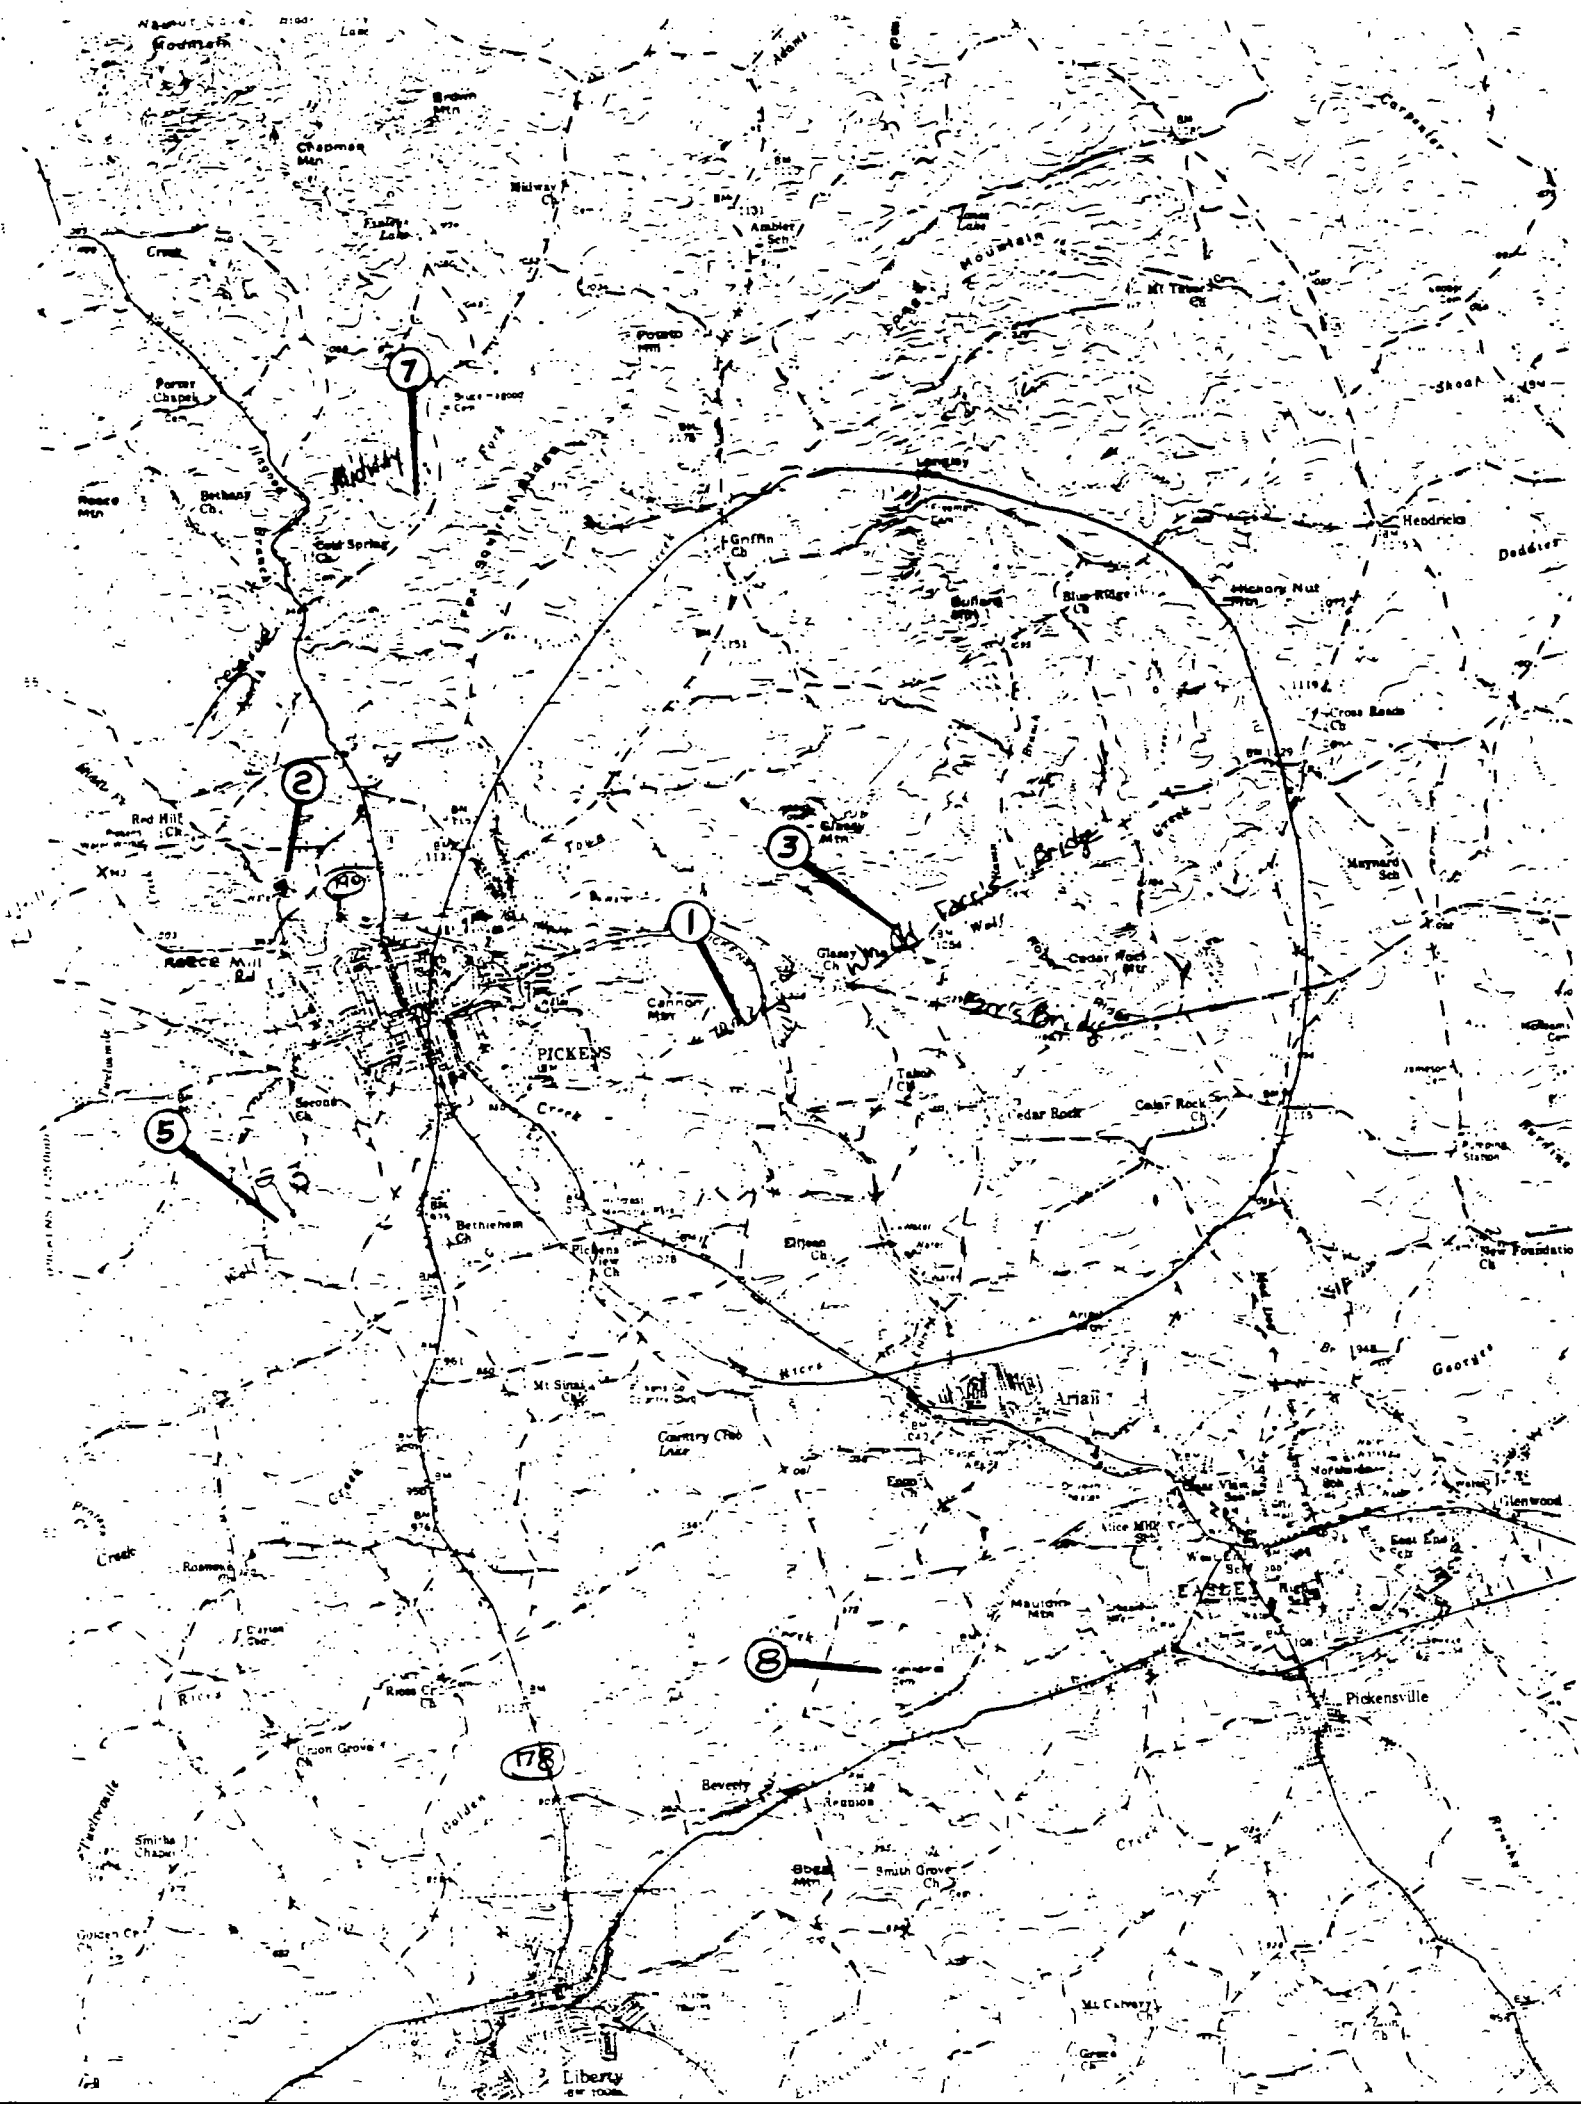

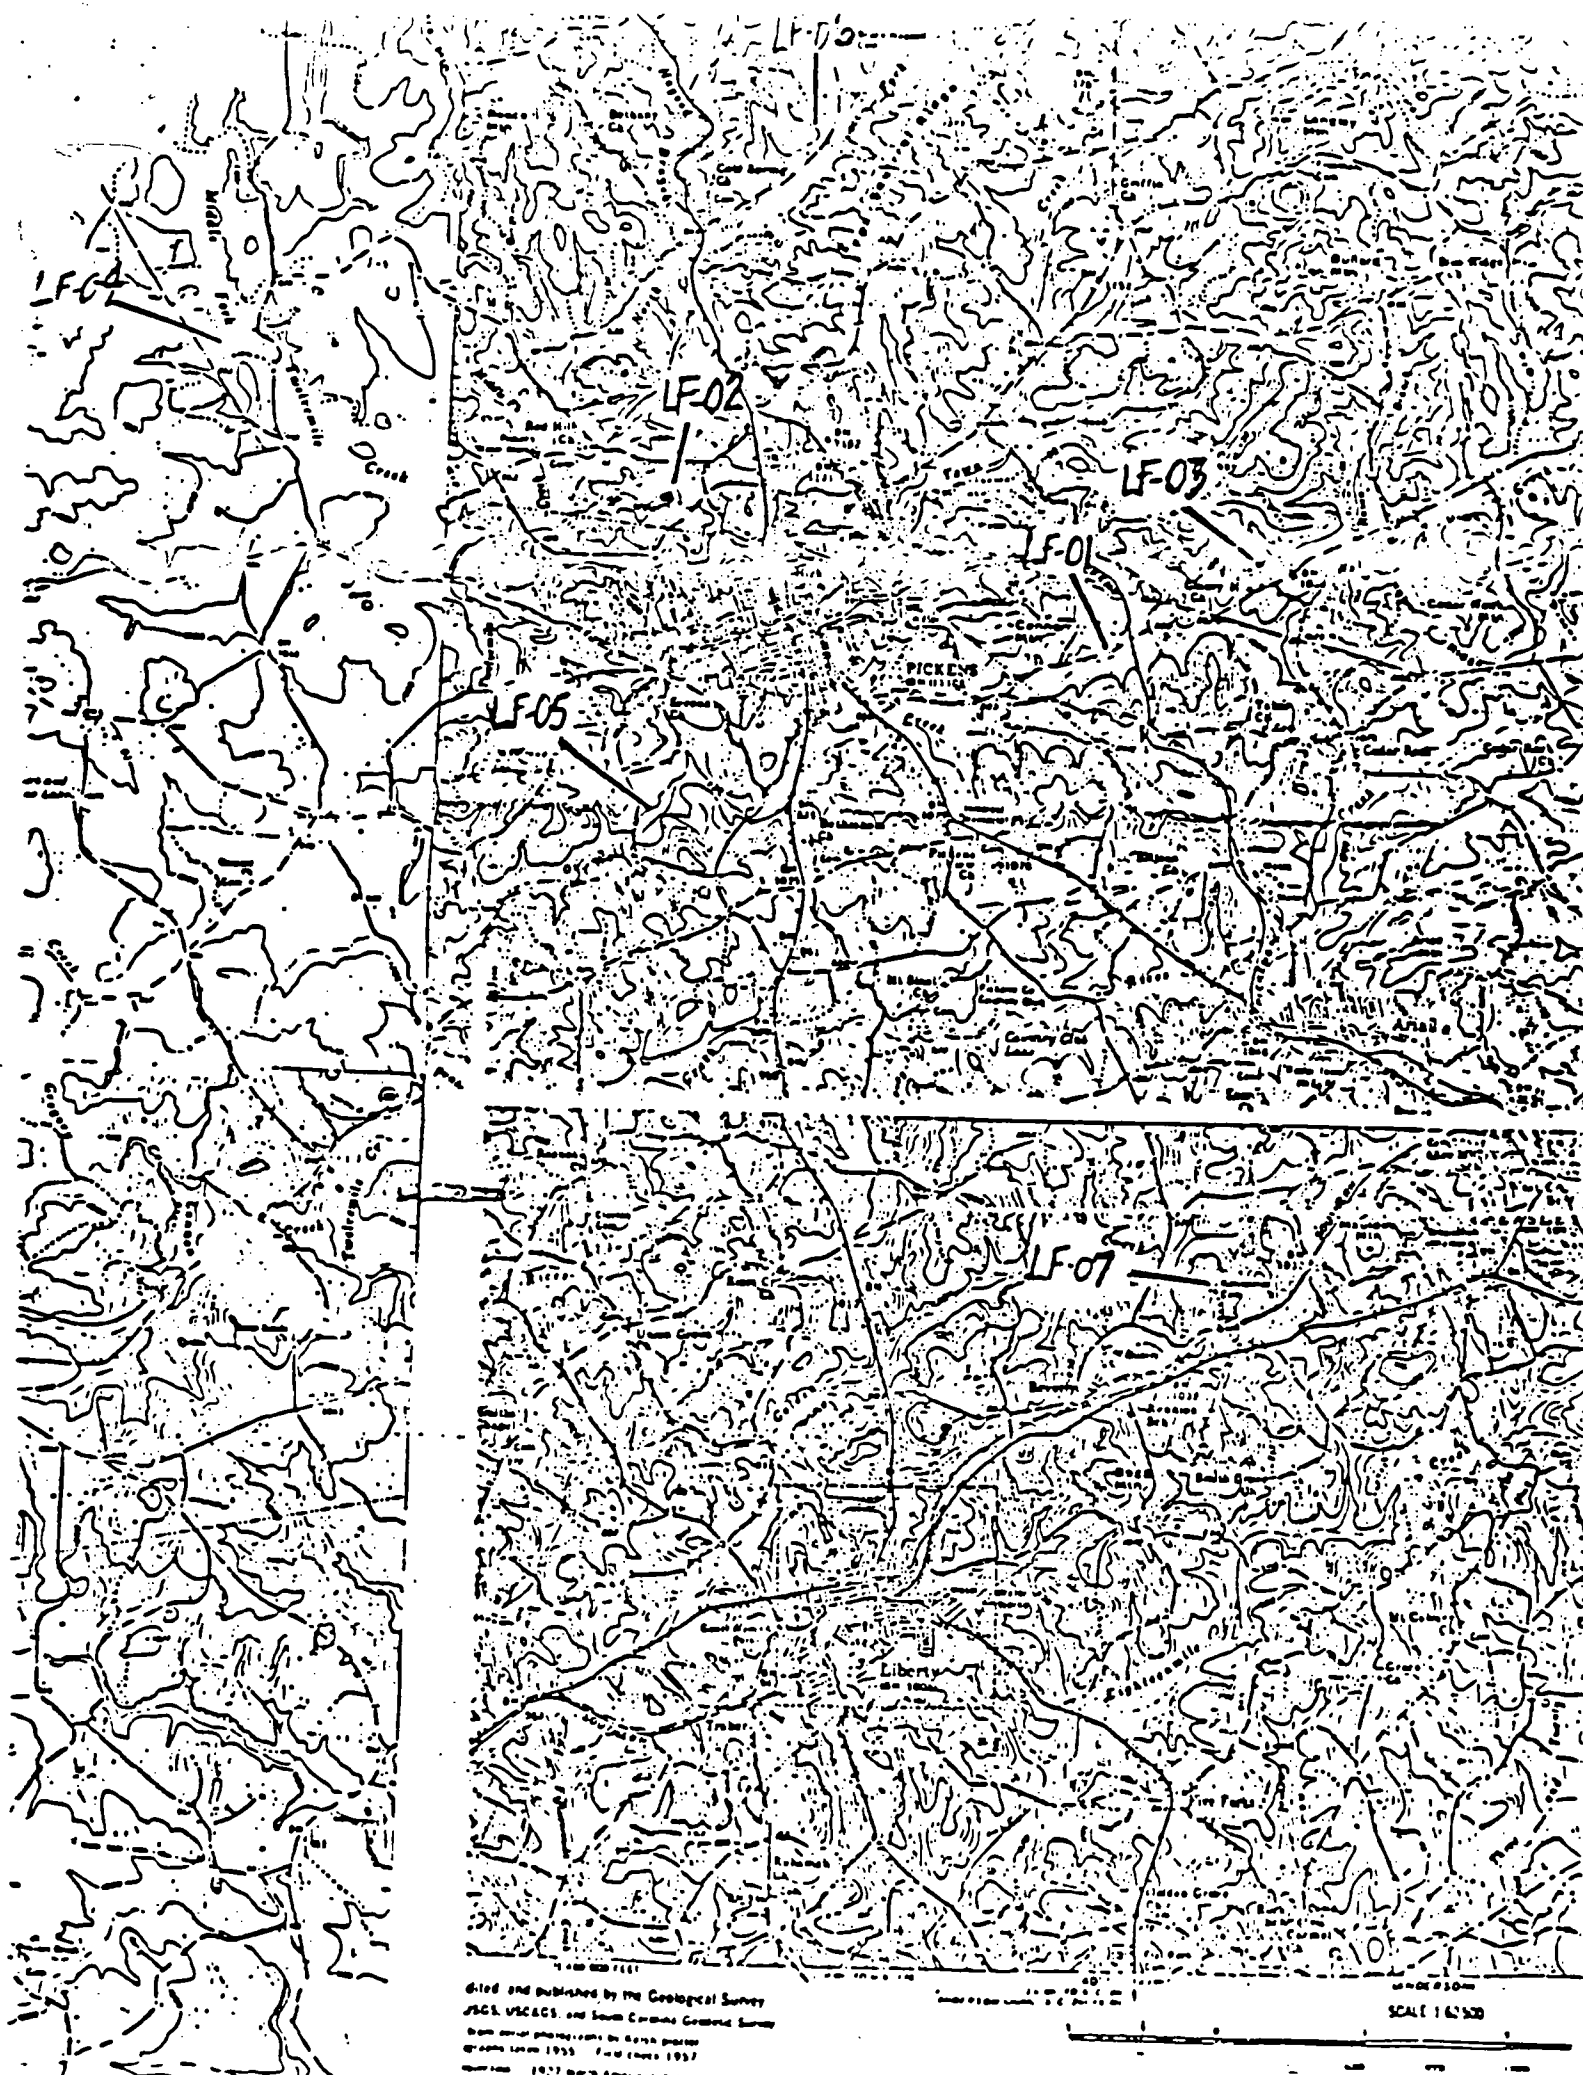

filed and published by the Geological Survey
USGS, USGCS, and South Carolina Geological Survey
from aerial photographs by North Carolina
Geological Survey 1955. Field notes 1957
Survey 1957 North Carolina

SCALE 1:62,500